



I CERTIFY THAT THE MEASUREMENTS SHOWN HEREON ARE CORRECT AND THAT THERE ARE NO ENCROACHMENTS OR PROJECTIONS UNLESS SHOWN.

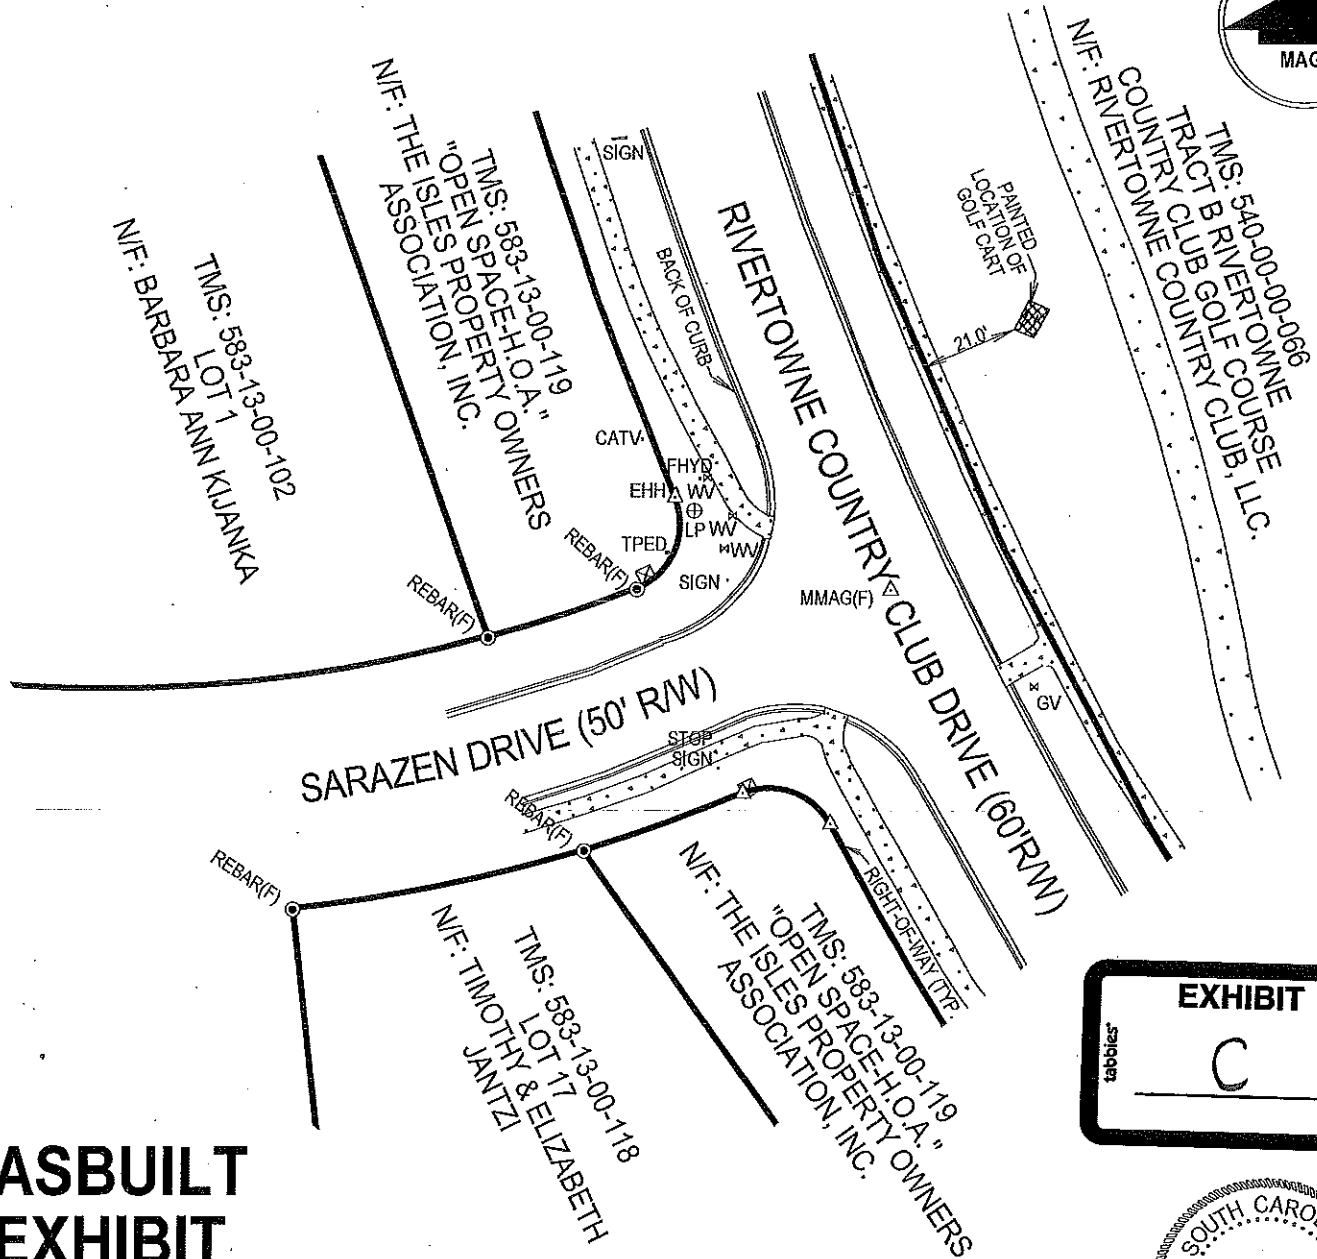

# ASBUILT EXHIBIT

SHOWING THE INTERSECTION OF RIVERTOWNE COUNTRY CLUB DRIVE & SARAZEN DRIVE, PHASES 1B1 & 4, PINE ISLES AT RIVERTOWNE COUNTRY CLUB DRIVE, TOWN OF MT. PLEASANT, CHARLESTON COUNTY. PREPARED FOR MAX SPARWASSER LAW FIRM, LLC.

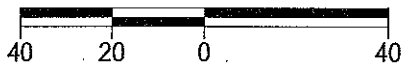



SCALE: 1" = 40'

DATE: MAY 13, 2016

REF: PLAT BK. "EE", PG. 388

TMS:AS SHOWN

ALEXANDER C. PEABODY, PLS.  
PEABODY & ASSOCIATES, INC.  
PROFESSIONAL LAND SURVEYING  
P.O. BOX 22646, CHARLESTON, SC 29413  
OFFICE 843-723-5225 MOBILE 843-270-4847

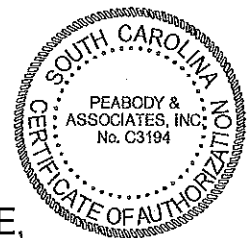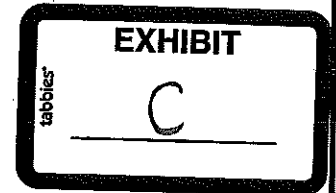

CHARLESTON COUNTY  
SOUTH CAROLINA